

BARRETTE OUTDOOR LIVING, INC. TEST REPORT

SCOPE OF WORK

STRUCTURAL PERFORMANCE TESTING ON THE 8 FT BY 42 IN *METAL WORKS EXCALIBUR - LATITUDES* STEEL GUARDRAIL SYSTEM

REPORT NUMBER

M1154.01-119-19 R0

TEST DATE

04/29/21

ISSUE DATE

05/18/21

RECORD RETENTION END DATE

04/29/25


PAGES

26

DOCUMENT CONTROL NUMBER

RT-R-AMER-Test-2846 (02/09/18)

© 2017 INTERTEK

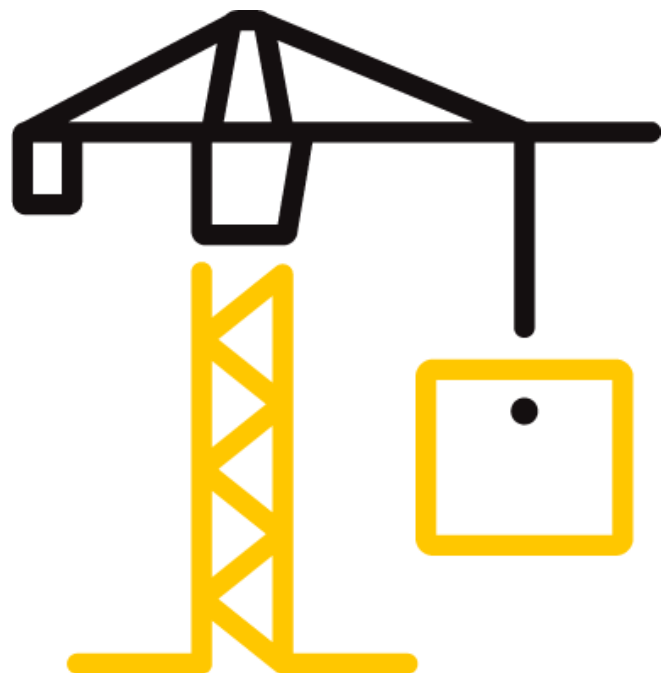

TEST REPORT FOR BARRETTE OUTDOOR LIVING, INC.

Report No.: M1154.01-119-19 R0

Date: 05/18/21

REPORT ISSUED TO

BARRETTE OUTDOOR LIVING, INC.

545 Tilton Road

Egg Harbor City, NJ 08215

SECTION 1

SCOPE

Intertek Building & Construction (B&C) was contracted by Barrette Outdoor Living, Inc. to perform structural performance testing in accordance with the 2018 IRC and IBC on their 8 ft (96 in) wide by 42 (in) high *Metal Works Excalibur - Latitudes* steel guardrail system. All tests performed were to evaluate structural performance of the guardrail assembly to carry and transfer imposed loads to the supporting structure. The test specimens evaluated included the infill, rails, rail brackets, and support posts (IRC loading only). Anchorage of support posts to the supporting structure is not included in the scope of this testing and would need to be evaluated separately.

Results obtained are tested values and were secured by using the designated test methods. Testing was conducted at Intertek test facility in York, Pennsylvania. This report does not constitute certification of this product nor an opinion or endorsement by this laboratory.

SECTION 2

SUMMARY OF TEST RESULTS

The specimens met the 2018 IBC and IRC design load performance requirements.

For INTERTEK B&C:

COMPLETED BY:	Adam J. Schrum
TITLE:	Project Manager
SIGNATURE:	
DATE:	05/18/21

REVIEWED BY:	V. Thomas Mickley, Jr., P.E.
TITLE:	Senior Staff Engineer
SIGNATURE:	
DATE:	05/18/21

AJS:vtm/aas

This report is for the exclusive use of Intertek's Client and is provided pursuant to the agreement between Intertek and its Client. Intertek's responsibility and liability are limited to the terms and conditions of the agreement. Intertek assumes no liability to any party, other than to the Client in accordance with the agreement, for any loss, expense or damage occasioned by the use of this report. Only the Client is authorized to permit copying or distribution of this report and then only in its entirety. Any use of the Intertek name or one of its marks for the sale or advertisement of the tested material, product or service must first be approved in writing by Intertek. The observations and test results in this report are relevant only to the sample(s) tested. This report by itself does not imply that the material, product, or service is or has ever been under an Intertek certification program.

TEST REPORT FOR BARRETTE OUTDOOR LIVING, INC.

Report No.: M1154.01-119-19 R0

Date: 05/18/21

SECTION 3

TEST METHODS

The specimens were evaluated in accordance with the following:

2018, *International Building Code*[®], International Code Council

2018, *International Residential Code*[®], International Code Council

Structural tests were performed according to Chapter 17 (Structural Tests and Special Inspections) of IBC 2018.

SECTION 4

MATERIAL SOURCE/INSTALLATION

Test samples were provided by the client. Representative samples of the test specimens will be retained by Intertek B&C for a minimum of four years from the test completion date.

The 8 ft (96 in) wide by 42 in high guardrail assembly was installed and tested as a single railing section by directly securing the posts into a rigid steel test fixture, which rigidly restrained the posts from deflecting (for IBC testing), or with the post mounts attached at the base to steel C-channels to represent simulated concrete condition (for IRC testing). Transducers mounted to an independent reference frame were located to record movement of reference points on the guardrail system components (ends and mid-point) to determine net component deflections. See photographs in Section 11 for individual test setups.

SECTION 5

EQUIPMENT

The guardrail was tested in a self-contained structural frame designed to accommodate anchorage of the guardrail assembly and application of the required test loads. The specimens were loaded using an electric winch mounted to a rigid steel test frame. High strength steel cables, nylon straps, and load distribution beams were used to impose test loads on the specimens. Applied load was measured using an electronic load cell located in-line with the loading system. Electronic linear motion transducers were used to measure deflections.

TEST REPORT FOR BARRETTE OUTDOOR LIVING, INC.

Report No.: M1154.01-119-19 R0

Date: 05/18/21

SECTION 6**LIST OF OFFICIAL OBSERVERS**

NAME	COMPANY
George Sarkees	Barrette Outdoor Living, Inc.
Joe Ciszek	Barrette Outdoor Living, Inc.
Adam J. Schrum	Intertek B&C

SECTION 7**TEST PROCEDURE**

Each test specimen was inspected prior to testing to verify size and general condition of the materials, assembly, and installation. No potentially compromising defects were observed prior to testing.

An initial load, not exceeding 50% of design load, was applied and transducers were zeroed. Load was then applied at a steady uniform rate until reaching 2.0 times design load in no less than 10 seconds. After reaching 2.0 times design load, the load was released. After allowing a minimum period of one minute for stabilization, load was reapplied to the initial load level used at the start of the loading procedure, and deflections were recorded and used to analyze recovery. Load was then increased at a steady uniform rate until reaching 2.5 times design load or until failure occurred. The testing time was continually recorded from the application of initial test load until the ultimate test load was reached.

Deflection and permanent set were component deflections relative to their end-points; they were not overall system displacements. All loads and displacement measurements were horizontal, unless noted otherwise.

TEST REPORT FOR BARRETTE OUTDOOR LIVING, INC.

Report No.: M1154.01-119-19 R0

Date: 05/18/21

SECTION 8

TEST SPECIMEN DESCRIPTION

Barrette Outdoor Living, Inc. provided the fully-assembled test specimens with the following details:

PRODUCT	<i>Metal Works Excalibur - Latitudes</i>
TYPE	Steel guardrail system
GUARDRAIL LENGTH	96 in (inside of post to inside of post)
GUARDRAIL HEIGHT	- 42 in (top of top rail to bottom of base plate) - 40 in (top of top rail to bottom of bottom rail)
TOP AND BOTTOM RAIL	1 in square steel tube with a 0.11 in thick wall
PICKETS (IN-FILL)	- Four vertical 1 in square steel tubes with 0.07 in wall, one at each end and at 1/3 points - Nine horizontal 1/2 in diameter steel tubes with 0.09 in wall equally spaced between the top and bottom rail
RAIL BRACKETS	1-1/4 in high by 1-5/16 in wide by 1 in long steel collar brackets (welded or mechanically fastened to post mount)
POST	2 in square by 0.08 in wall hollow steel post welded to a 3-13/16 in square by 1/4 in thick steel base plate with a 1/8 in fillet weld all around; the base plate included four 7/16 in diameter holes and one 1 in square hole

Fastening Schedule

CONNECTION	FASTENER
Bracket to Post (IRC only)	1/16 in fillet weld on three sides
Bracket to Post (IBC and IRC)	Two, #10-16 by 5/8" (0.130 in minor diameter) flat head, torx drive, self-drilling, stainless steel screws
Top/Bottom Rail to Bracket	Two, #10-16 by 5/8" (0.130 in minor diameter) flat head, torx drive, self-drilling, stainless steel screws
Vertical Picket (First and Last) to Top/Bottom Rail	One, M5-1.75 by 19mm (0.122 in minor diameter) hex-washer head, self-drilling, steel screw
Vertical Picket (Located at Third Points) to Top/Bottom Rail	Butt welded on two sides and fillet welded on two sides
Horizontal Picket to First and Last Vertical Picket	Compression fit into plastic grommet; No mechanical connection
Horizontal Picket to 1/3 Point Vertical Pickets	Fillet welded all around

TEST REPORT FOR BARRETTE OUTDOOR LIVING, INC.

Report No.: M1154.01-119-19 R0

Date: 05/18/21

SECTION 9

TEST RESULTS

Key to Test Results Tables:

Load Level: Target test load

Test Load: Actual applied load at the designated load level (target).

Elapsed Time (E.T.): The amount of time into the test with zero established at the beginning of the loading procedure.

Test Series No. 1

8 ft (96 in) by 42 in Metal Works Excalibur - Latitudes Steel Guardrail with Posts Restrained in Stanchions

IBC - All Use Groups

Test No. 1 - 04/29/21

Design Load: 50 lb / 1 Square ft at Center of In-fill (on 3 Pickets)

LOAD LEVEL	TEST LOAD (lb)	E.T. (min:sec)	DISPLACEMENT (in)			
			END	MID	END	NET
Initial Load	25	00:00	--	0.00	--	--
2.0x Design Load	103	00:10	--	0.49	--	--
Initial Load	25	01:29	--	0.00	--	--
100% Recovery from 2.0 x Design Load						
2.5x Design Load	129	01:36	Achieved Load without Failure			

Test No. 2 - 04/29/21

Design Load: 50 lb / 1 Square ft at Bottom of In-fill (on 3 Pickets)

LOAD LEVEL	TEST LOAD (lb)	E.T. (min:sec)	DISPLACEMENT (in)			
			END	MID	END	NET
Initial Load	25	00:00	--	0.00	--	--
2.0x Design Load	107	00:10	--	0.61	--	--
Initial Load	25	01:21	--	0.00	--	--
100% Recovery from 2.0 x Design Load						
2.5x Design Load	135	01:30	Achieved Load without Failure			

TEST REPORT FOR BARRETTE OUTDOOR LIVING, INC.

Report No.: M1154.01-119-19 R0

Date: 05/18/21

Test No. 3 - 04/29/21

Design Load: 50 lb/ft x (96 in ÷ 12 in/ft) = 400 lb Horizontal Uniform Load On Top Rail ²

LOAD LEVEL	TEST LOAD (lb)	E.T. (min:sec)	RAIL DISPLACEMENT (in)			
			END	MID	END	NET ¹
Initial Load	80	00:00	0.00	0.00	0.00	0.00
2.0x Design Load	805	01:01	0.14	4.99	0.09	4.88
Initial Load	80	02:41	0.02	0.89	0.00	0.88
82% Recovery from 2.0 x Design Load						
2.5x Design Load	1001	03:21	Achieved Load without Failure			

¹ Net displacement was mid-rail displacement relative to the rail at the support posts.

² Uniform load was simulated with quarter point loading.

Test No. 4 - 04/29/21

Design Load: 50 lb/ft x (96 in ÷ 12 in/ft) = 400 lb Vertical Uniform Load On Top Rail ¹

LOAD LEVEL	TEST LOAD (lb)	E.T. (min:sec)	RAIL DISPLACEMENT (in)			
			END	MID	END	NET
Initial Load	80	00:00	--	0.00	--	--
2.0x Design Load	806	00:49	--	1.19	--	--
Initial Load	80	02:16	--	0.12	--	--
90% Recovery from 2.0 x Design Load						
2.5x Design Load	1003	02:45	Achieved Load without Failure			

¹ Uniform load was simulated with quarter point loading.

Test No. 5 - 04/29/21

Design Load: 200 lb Horizontal Concentrated Load at Midspan of Top Rail

LOAD LEVEL	TEST LOAD (lb)	E.T. (min:sec)	RAIL DISPLACEMENT (in)			
			END	MID	END	NET ¹
Initial Load	50	00:00	0.00	0.00	0.00	0.00
2.0x Design Load	406	00:30	0.05	3.23	0.03	3.19
Initial Load	50	01:56	0.00	0.09	0.00	0.09
97% Recovery from 2.0 x Design Load						
2.5x Design Load	503	02:26	Achieved Load without Failure			

¹ Net displacement was mid-rail displacement relative to the rail at the support posts.

TEST REPORT FOR BARRETTE OUTDOOR LIVING, INC.

Report No.: M1154.01-119-19 R0

Date: 05/18/21

Test No. 6 - 04/29/21

Design Load: 200 lb Horizontal Concentrated Load at Ends of Top Rail (Brackets)

LOAD LEVEL ¹	TEST LOAD (lb)	E.T. (min:sec)	RAIL DISPLACEMENT (in)	
			RAIL END #1	RAIL END #2
Initial Load	80	00:00	0.00	0.00
(2.0x Design Load) x 2	808	00:24	0.25	0.22
Initial Load	80	01:49	0.01	0.01
95% Recovery (Rail End #1) and 95% Recovery (Rail End #2) from 2.0 x Design Load				
(2.5x Design Load) x 2	1010	02:14	Achieved Load without Failure	

¹ A spreader beam was used to impose loads on both ends of the railing system; therefore, loads were doubled.

Test Series No. 2

8 ft (96 in) by 42 in Metal Works Excalibur - Latitudes Steel Guardrail with Posts Installed in Simulated Concrete Condition

IRC - One- and Two-Family Dwellings

Test No. 1 - 04/29/21

Design Load: 50 lb / 1 Square ft at Center of In-fill (on 3 Pickets)

LOAD LEVEL	TEST LOAD (lb)	E.T. (min:sec)	DISPLACEMENT (in)			
			END	MID	END	NET
Initial Load	25	00:00	--	0.00	--	--
2.0x Design Load	104	00:10	--	0.50	--	--
Initial Load	25	01:27	--	0.00	--	--
100% Recovery from 2.0 x Design Load						
2.5x Design Load	125	01:51	Achieved Load without Failure			

Test No. 2 - 04/29/21

Design Load: 50 lb / 1 Square ft at Bottom of In-fill (on 3 Pickets)

LOAD LEVEL	TEST LOAD (lb)	E.T. (min:sec)	DISPLACEMENT (in)			
			END	MID	END	NET
Initial Load	25	00:00	--	0.00	--	--
2.0x Design Load	100	00:10	--	0.49	--	--
Initial Load	25	01:18	--	0.00	--	--
100% Recovery from 2.0 x Design Load						
2.5x Design Load	127	01:33	Achieved Load without Failure			

TEST REPORT FOR BARRETTE OUTDOOR LIVING, INC.

Report No.: M1154.01-119-19 R0

Date: 05/18/21

Test No. 3 - 04/29/21

Design Load: 200 lb Horizontal Concentrated Load at Midspan of Top Rail

LOAD LEVEL	TEST LOAD (lb)	E.T. (min:sec)	RAIL DISPLACEMENT (in)			
			END	MID	END	NET ¹
Initial Load	50	00:00	0.00	0.00	0.00	0.00
2.0x Design Load	407	00:46	0.89	4.30	0.84	3.44
Initial Load	50	02:12	0.02	0.45	0.03	0.43
88% Recovery from 2.0 x Design Load						
2.5x Design Load	503	03:02	Achieved Load without Failure			

¹ Net displacement was mid-rail displacement relative to the rail at the support posts.

Test No. 4 - 04/29/21

Design Load: 200 lb Horizontal Concentrated Load at Ends of Top Rail (Brackets)

LOAD LEVEL ¹	TEST LOAD (lb)	E.T. (min:sec)	RAIL DISPLACEMENT (in)	
			RAIL END #1	RAIL END #2
Initial Load	80	00:00	0.00	0.00
(2.0x Design Load) x 2	803	00:52	2.11	2.30
Initial Load	80	02:18	0.15	0.24
93% Recovery (Rail End #1) and 90% Recovery (Rail End #2) from 2.0 x Design Load				
(2.5x Design Load) x 2	1005	03:01	Achieved Load without Failure	

¹ A spreader beam was used to impose loads on both ends of the railing system; therefore, loads were doubled.

Test No. 5 - 04/29/21

Design Load: 200 lb Concentrated Load at Top of Stand-Alone ¹ Post (42 in high)

LOAD LEVEL	TEST LOAD (lb)	E.T. (min:sec)	POST DISPLACEMENT (in)
Initial Load	40	00:00	0.00
2.0x Design Load	409	00:25	1.84
Initial Load	40	01:46	0.02
99% Recovery from 2.0 x Design Load			
2.5x Design Load	503	02:25	Achieved Load without Failure

¹ Post was conservatively tested without a railing attached.

TEST REPORT FOR BARRETTE OUTDOOR LIVING, INC.

Report No.: M1154.01-119-19 R0

Date: 05/18/21

**SECTION 10
CONCLUSION**

Using performance criteria of withstanding an ultimate load of 2.5 times design load, the test results substantiate compliance with the design load requirements for the building codes and guardrail details shown in the following table:

METAL WORKS EXCALIBUR - LATITUDES	GUARDRAIL TYPE	SUPPORT POST	BRACKET TO POST CONNECTION	CODE OCCUPANCY CLASSIFICATION
8 ft (96 in) by 42 in	Level / In- Line Application	-- ¹	Mechanically Connected	IBC - All Use Groups
		2 in Square Steel Post Mount Attached to Simulated Concrete	Mechanically Connected or Welded	IRC - One- and Two-Family Dwellings

¹Support posts are not included in the scope of the IBC evaluation documented in this report and would need to be evaluated separately.

Anchorage of support posts to the supporting structure is not included in the scope of this testing and would need to be evaluated separately.

TEST REPORT FOR BARRETTE OUTDOOR LIVING, INC.

Report No.: M1154.01-119-19 R0

Date: 05/18/21

SECTION 11 PHOTOGRAPHS



Photo No. 1
In-Fill Load Test at Center of Three Pickets



Photo No. 2
In-Fill Load Test at Bottom of Three Pickets

TEST REPORT FOR BARRETTE OUTDOOR LIVING, INC.

Report No.: M1154.01-119-19 R0

Date: 05/18/21



Photo No. 3
Horizontal Uniform Load on Top Rail (IBC Loading Only)



Photo No. 4
Vertical Uniform Load on Top Rail (IBC Loading Only)

TEST REPORT FOR BARRETTE OUTDOOR LIVING, INC.

Report No.: M1154.01-119-19 R0

Date: 05/18/21



Photo No. 5
Concentrated Load Test at Midspan of Top Rail



Photo No. 6
Concentrated Load Test at Ends of Top Rail (Brackets)

TEST REPORT FOR BARRETTE OUTDOOR LIVING, INC.

Report No.: M1154.01-119-19 R0

Date: 05/18/21



Photo No. 7

Concentrated Load Test at Top of Stand-Alone Post (42 in high)



Photo No. 8

Bracket Connection to Post and Rail



Total Quality. Assured.

130 Derry Court
York, Pennsylvania 17406

Telephone: 717-764-7700
Facsimile: 717-764-4129
www.intertek.com/building

TEST REPORT FOR BARRETTE OUTDOOR LIVING, INC.

Report No.: M1154.01-119-19 R0


Date: 05/18/21

SECTION 12 DRAWINGS

The "As-Built" drawings for the 8 ft (96 in) wide by 42 (in) high *Metal Works Excalibur - Latitudes* steel guardrail system which follow have been reviewed by Intertek B&C and are representative of the project reported herein. Project construction was verified by Intertek B&C per the drawings included in this report. Any deviations are documented herein or on the drawings.

NOTES:

1. MATERIAL: Q235 STEEL
2. USE WITH EPN-4258 BRACKET COVER
3. AAMA 2604 POWDER COAT PART BLACK OR BRONZE
4. SEE CAD FILE FOR ALL DIMENSIONS

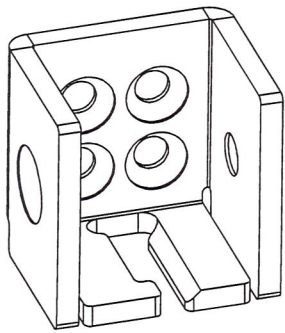



SCALE 1 : 1

Test sample complies with these details.
Deviations are noted.

Report #5° M1154-01-119-19

Date 5/11/21 Tech AJS

DETAIL A
SCALE 3 : 1

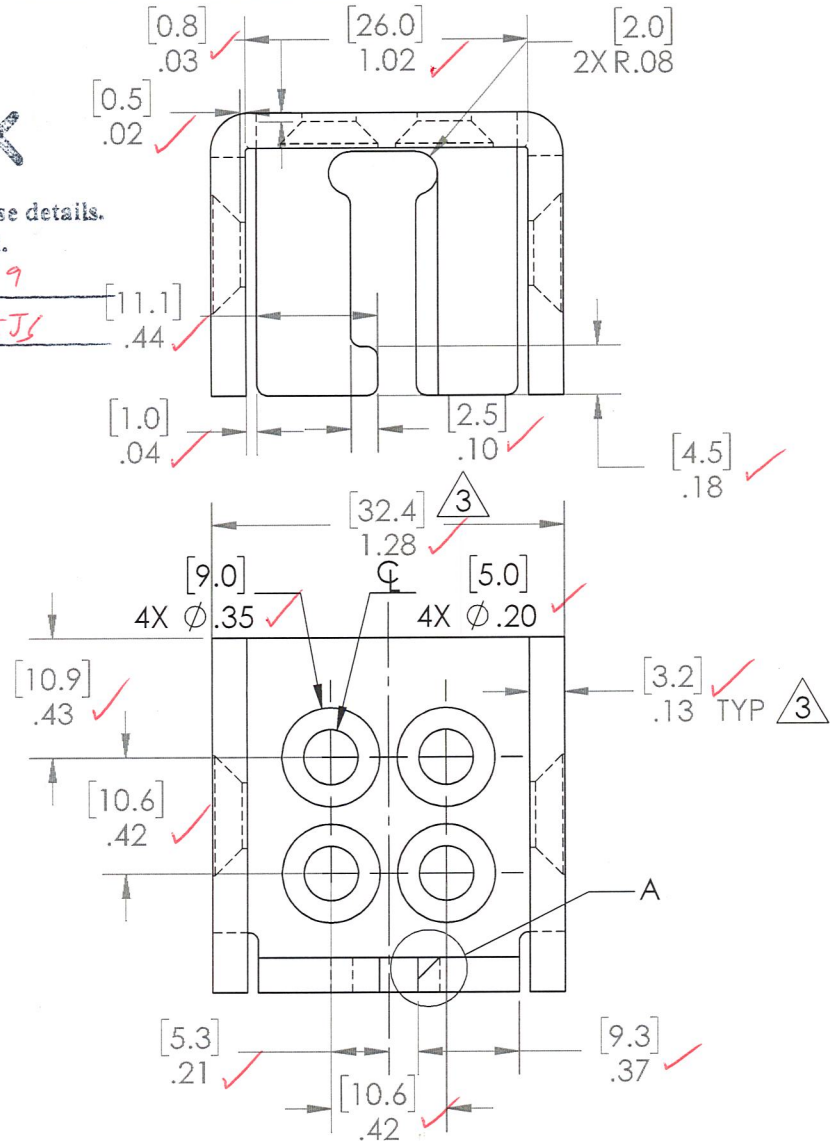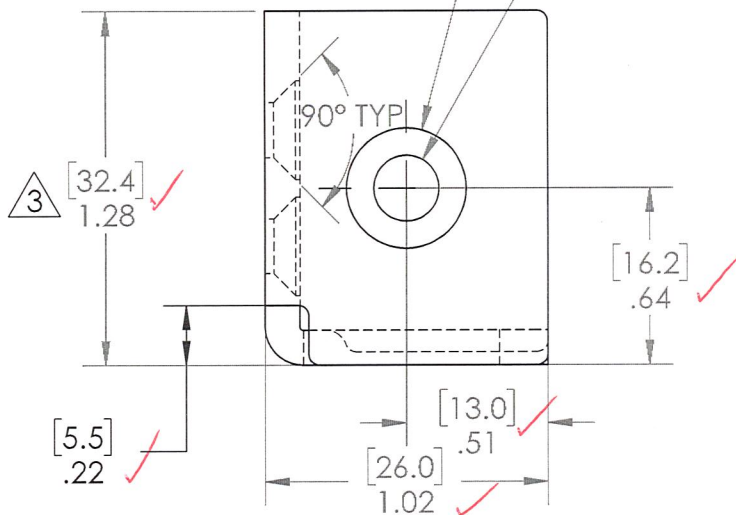


THE INFORMATION CONTAINED IN THIS DRAWING IS PROTECTED BY COPYRIGHT AND PATENT LAWS OF THE UNITED STATES AND OTHER COUNTRIES. ANY REPRODUCTION IN PART OR AS A WHOLE WITHOUT WRITTEN PERMISSION IS PROHIBITED.

REV	BY	DATE	PCR	DESCRIPTION
3	CH	10/30/2020	N/A	ADDED MISSING DIMS, ADD Q235 TO MATERIAL SPEC.
2	CH	8/3/2020	N/A	ADDED MISSING DIM (26mm)
1	CH	6/9/2020	N/A	ADDED 2mm RADIUS CUT ON BOTTOM AT END OF CHAMFER.
0	CH	6/3/2020	N/A	ADD RADIUS AT END OF CHAMFER. RELEASE FOR PRODUCTION.

TOLERANCES	
FRACTION	±1/16
XX	±0.01
XXX	±0.005
ANGLE	±1.0°
FINISH	125 RMS
UNLESS OTHERWISE SPECIFIED	

		BARRETTE Outdoor Living 740 N. Main St., Bulls Gap, TN 37711	
		DRAWN: C HERITAGE DATE: 05/27/2020 APPROVED: PS	REVISION: 3 PART NUMBER: EPN-4257
METAL WORKS EXCALIBUR LOOSE LEVEL BRACKET			
SHEET 1 OF 1		SCALE 3:2	
WEIGHT:			

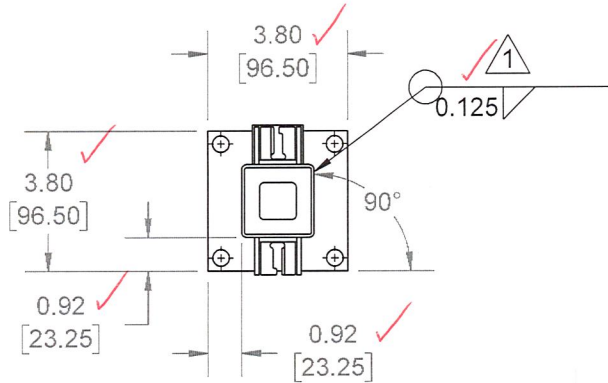

NOTES:



1. MATERIAL: GALVANIZED STEEL Q235.
2. FINISH: POWDER COAT BLACK (AAMA 2604-13).
3. EPN-3010 MUST BE CENTERED AND WELDED TO EPN-4109.
4. EPN-4259 MUST BE CENTERED AND WELDED TO EPN-3010.

intertek



Test sample complies with these details.
Deviations are noted.

Report # M1154-01-119-19

Date 5/11/21 Tech AJS

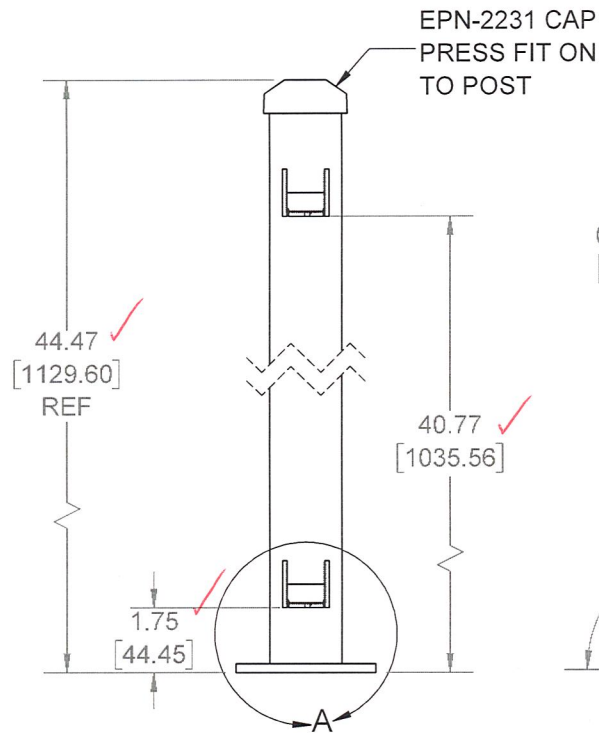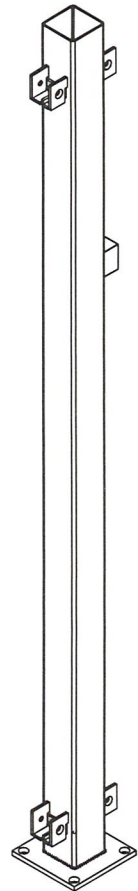

BRACKET DIMENSION FROM BOTTOM OF THE PLATE TO THE BOTTOM OF THE BRACKET

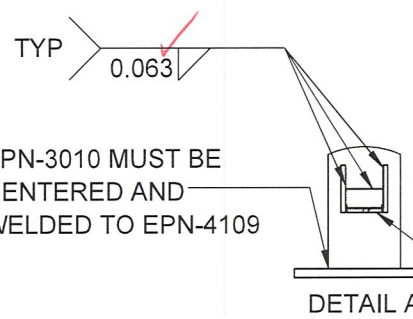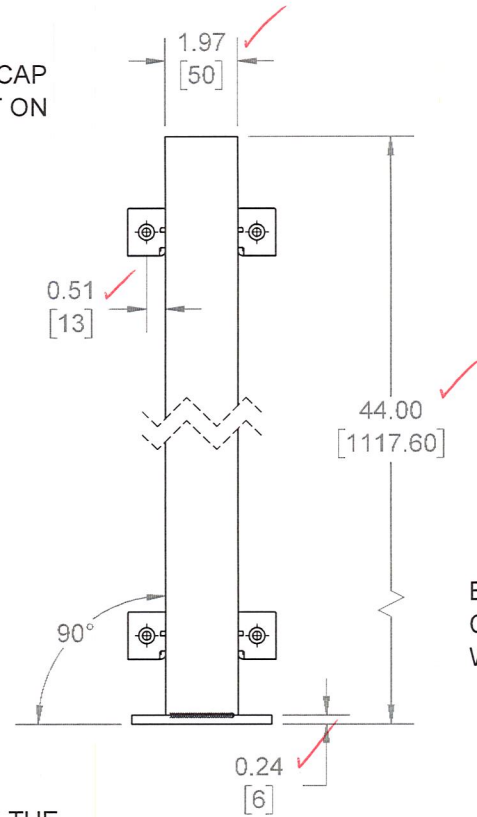

THE INFORMATION CONTAINED IN THIS DRAWING IS PROTECTED BY COPYRIGHT AND PATENT LAWS OF THE UNITED STATES AND OTHER COUNTRIES. ANY REPRODUCTION IN PART OR AS A WHOLE WITHOUT WRITTEN PERMISSION IS PROHIBITED.


REV	BY	DATE	PCR	DESCRIPTION
2	CMJ	11/3/2020	201105CJH-A	CHANGED EPN-4110 TO EPN-4259 CHANGED EPN-4111 TO EPN-4258
1	CMJ	9/29/2020	N/A	UPDATE SPEC. WELD ON POST PLATE

TOLERANCES	
FRACTION	±1/16
XX	±0.01
XXX	±0.005
ANGLE	±1.0°
FINISH	125 RMS
UNLESS OTHERWISE SPECIFIED	

		BARRETTE Outdoor Living 740 N. Main St., Bulls Gap, TN 37711	
		DRAWN: PSackett	DATE: 12/04/2014
DESCRIPTION: 44" Mid Post Assembly for 42" Rail			
SHEET 2 OF 2 SCALE 1:10 WEIGHT: 8.746070		REVISION: 2	PART NUMBER: 73018349

NOTES:

1. MATERIAL: GALVANIZED STEEL Q235
2. LENGTH TOLERANCE:
 - <96" = 1/16"
 - >96" = 1/8"

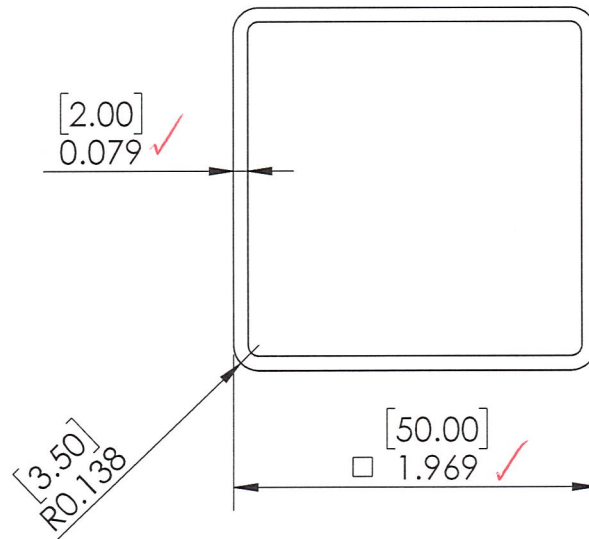



intertek

Test sample complies with these details.
Deviations are noted.

Report # M1154.01-119-19
Date 5/11/21 Tech AJS


THE INFORMATION CONTAINED IN THIS DRAWING IS PROTECTED BY COPYRIGHT AND PATENT LAWS OF THE UNITED STATES AND OTHER COUNTRIES. ANY REPRODUCTION IN PART OR AS A WHOLE WITHOUT WRITTEN PERMISSION IS PROHIBITED.

REV	BY	DATE	PCR	DESCRIPTION
0	WED	10/5/2020	N/A	RELEASED

		BARRETTE Outdoor Living	
DRAWN: W DIXON	DATE: 10/05/2020	APPROVED:	
DESCRIPTION: METALWORKS EXCALBUR 2" POST			
SHEET 1 OF 1	REVISION: 	PART NUMBER: EPN-3010	
SCALE 1:1			
WEIGHT: 1.001574			

NOTES:

1. MATERIAL: GALVANIZED TUBE STEEL Q235.
2. STEEL TUBING TO BE POWDER COATED IN MATTE BLACK OR MATTE BRONZE.
3. DIMENSIONS SHOWN DO NOT INCLUDE POWDER COAT.
4. POWDER COAT THICKNESS RANGE BETWEEN .003-.006 INCHES ON EACH SURFACE.
5. POWDER COAT PROCESS WILL BE THE SAME AS METALWORKS EXCALIBUR PARTS.
6. SEE ASSEMBLY DRAWINGS FOR PART LENGTH.

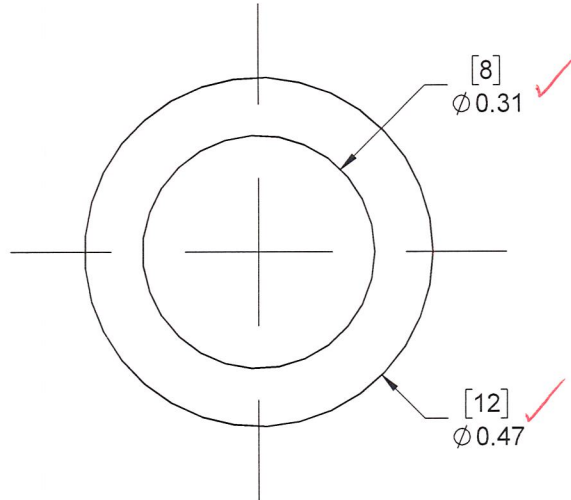

intertek



Test sample complies with these details.
Deviations are noted.

Report # M1154.01-119-19

Date 5/11/21 Tech AJS

THE INFORMATION CONTAINED IN THIS DRAWING IS PROTECTED BY COPYRIGHT AND PATENT LAWS OF THE UNITED STATES AND OTHER COUNTRIES. ANY REPRODUCTION IN PART OR AS A WHOLE WITHOUT WRITTEN PERMISSION IS PROHIBITED.

0	CH	7/7/2020	N/A	RELEASE FOR PRODUCTION
A	SRM	2/10/2020	N/A	PRELIMINARY DRAWING
REV	BY	DATE	PCR	DESCRIPTION

TOLERANCES				BARRETTE Outdoor Living	
FRACTION	±1/16	DRAWN	S. MARIN	DATE	02/03/2020
XX	±0.01	APPROVED	MW		
XXX	±0.005	DESCRIPTION: SR 12MM ROUND HOR			
ANGLE	±1.0°	SHEET 1 OF 1	REVISION	PART NUMBER	
FINISH	125 RMS	SCALE 2:1		EPN-3061	
UNLESS OTHERWISE SPECIFIED		WEIGHT: 0.33			

NOTES:



1. GALVANIZED STEEL FLANGE, TYPE Q345.
2. PLATE WELDED TO TUBE OF POST ON ALL SIDES.
3. USED FOR BASE OF ALL 2" POST ASSEMBLIES.
4. POWDER COAT PART BLACK OR BRONZE (AFTER WELDING).

intertek


Test sample complies with these details.
Deviations are noted.

Report # M1154.01-119-19

Date 5/11/21 Tech AJS

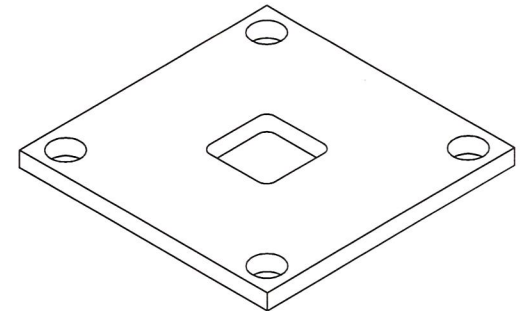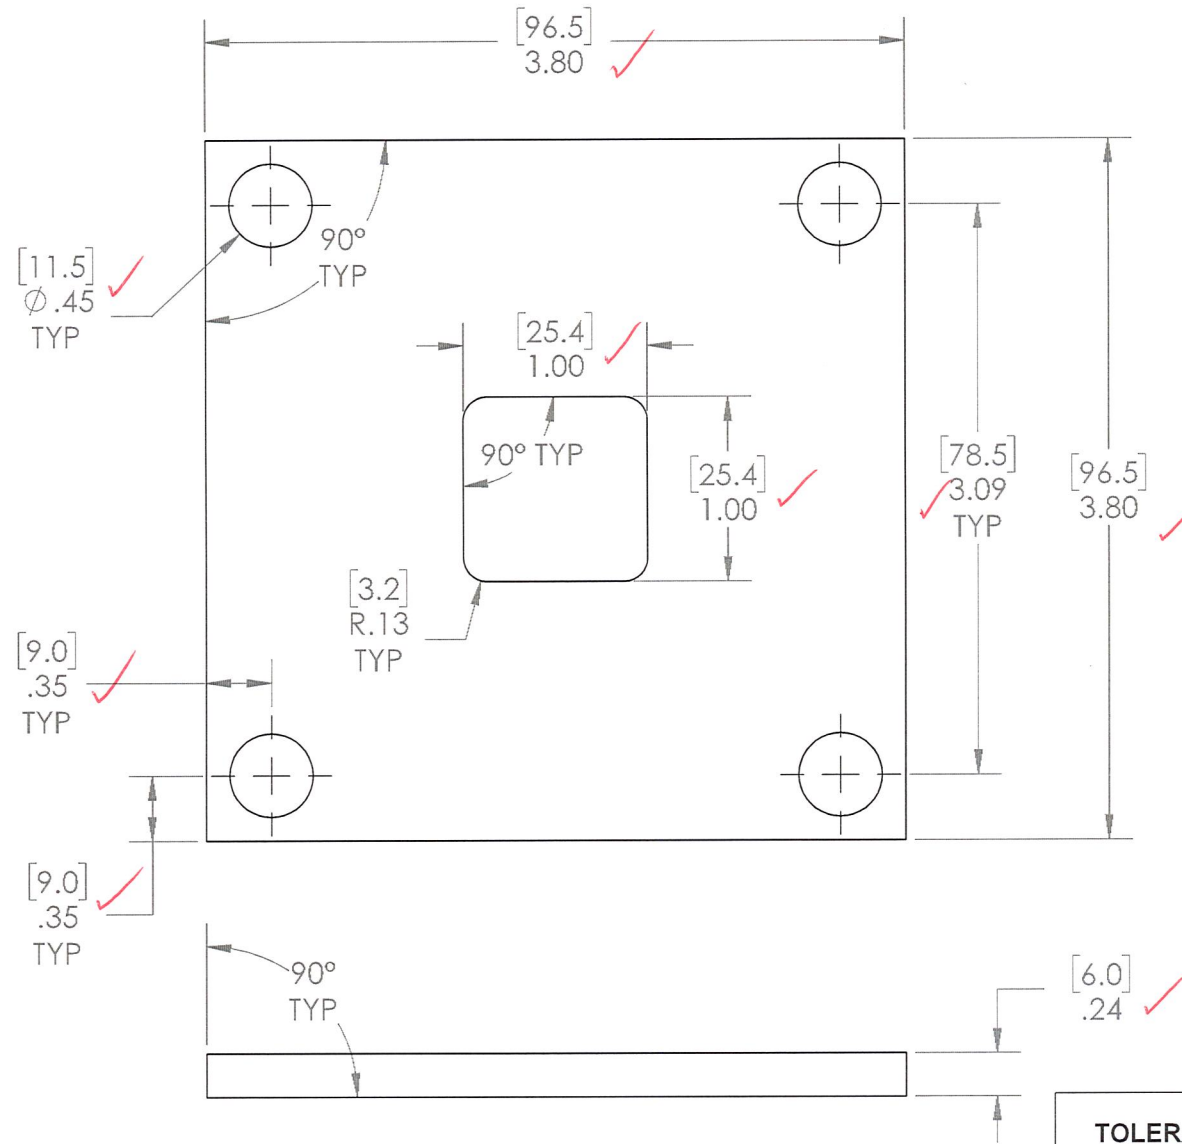

SCALE 1 : 2

TOLERANCES		 BARRETTE Outdoor Living 740 N. Main St., Bulls Gap, TN 37711	
FRACTION	±1/16	DRAWN: PSackett	DATE: 12/11/2014 APPROVED: PS
XX	±0.01	DESCRIPTION: POST FLANGE	
XXX	±0.005		
ANGLE	±1.0°		
FINISH	125 RMS		
UNLESS OTHERWISE SPECIFIED		SHEET 1 OF 1	REVISION: 1 PART NUMBER: EPN-4109
		SCALE 1:1	
		WEIGHT: 0.859927	

THE INFORMATION CONTAINED IN THIS DRAWING IS PROTECTED BY COPYRIGHT AND PATENT LAWS OF THE UNITED STATES AND OTHER COUNTRIES. ANY REPRODUCTION IN PART OR AS A WHOLE WITHOUT WRITTEN PERMISSION IS PROHIBITED.

REV	BY	DATE	PCR	DESCRIPTION
1	CH	3/25/2021	210325CJH-B	SPECIFIED MATERIAL TO BE Q345 STEEL. ADDED TOL TABLE. ADDED TYP AND REMOVED EXTRA DIMS.



NOTES:

1. MATERIAL: Q235 STEEL
2. USE WITH EPN-4258 BRACKET COVER
3. AAMA 2604 POWDER COAT PART BLACK OR BRONZE
4. SEE CAD FILE FOR ALL DIMENSIONS

intertek



Test sample complies with these details.
Deviations are noted.

Report # M1154-01-119-19
Date 5/11/21 Tech AJS

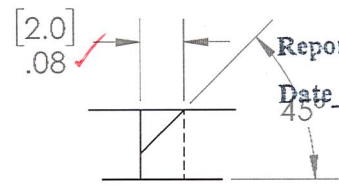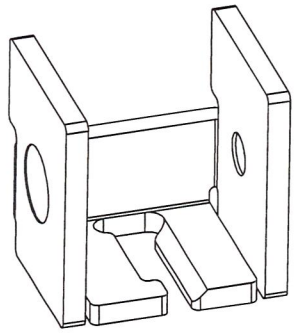

DETAIL A
SCALE 3:1

SCALE 1:1

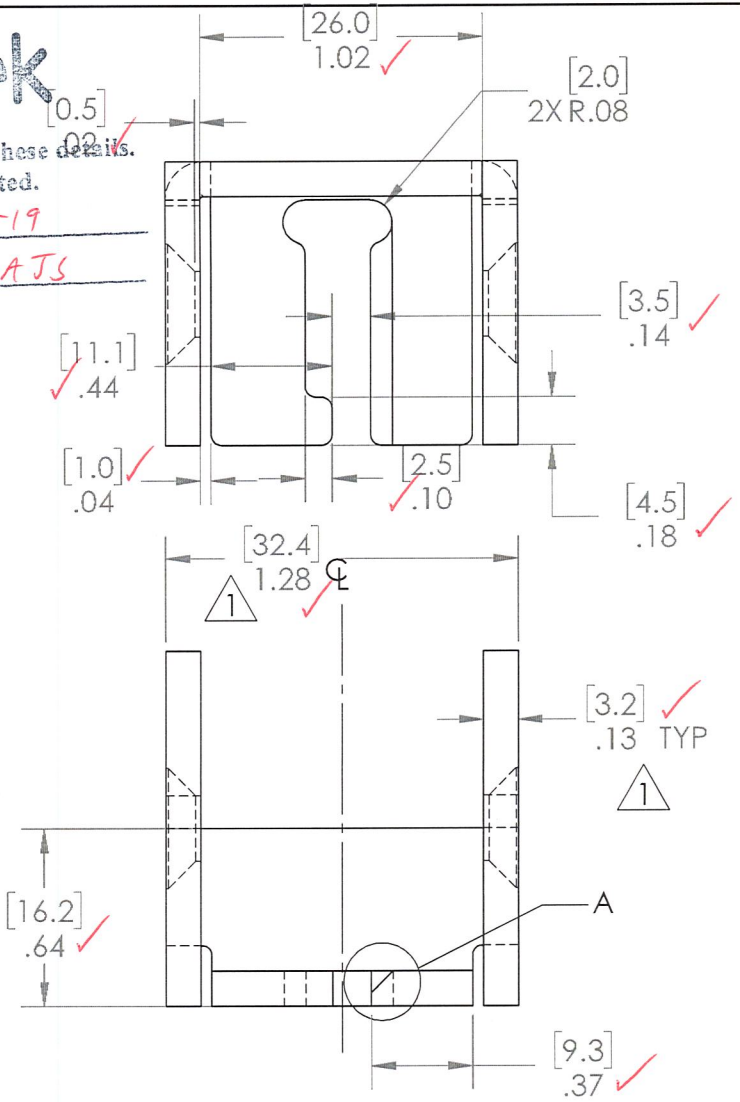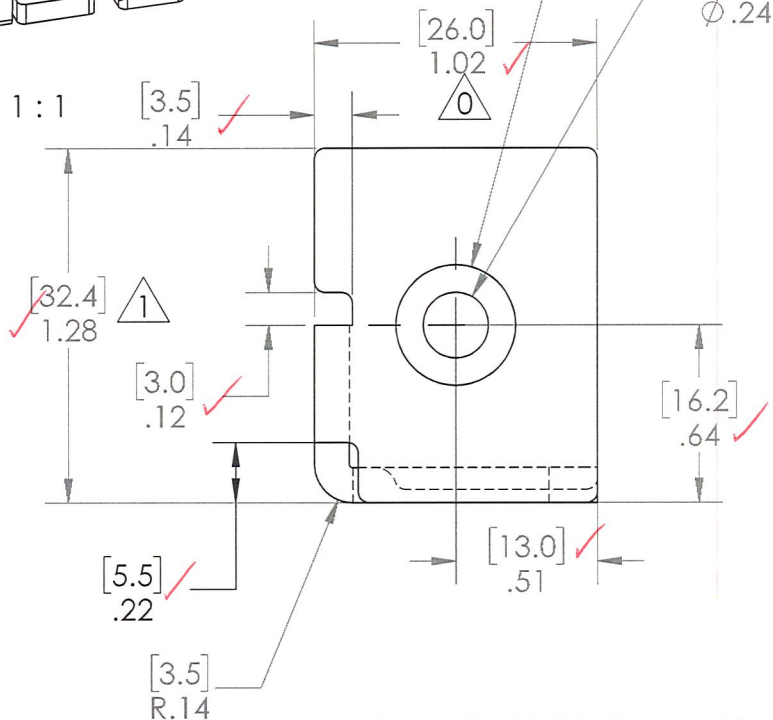

TOLERANCES	
FRACTION	±1/16
XX	±0.01
XXX	±0.005
ANGLE	±1.0°
FINISH	125 RMS
UNLESS OTHERWISE SPECIFIED	

Barrette
Outdoor Living
740 N. Main St., Bulls Gap, TN 37711

DRAWN: C HERITAGE DATE: 06/15/2020 APPROVED: SG

DESCRIPTION: **METAL WORKS EXCALIBUR WELDED LEVEL BRACKET**

SHEET 1 OF 1 REVISION: 1 PART NUMBER: **EPN-4259**

SCALE 3:2 WEIGHT:

REV	BY	DATE	PCR	DESCRIPTION
1	CH	10/30/2020	N/A	ADD MISSING DIMS. ADD Q235 TO STEEL SPEC.
0	CH	8/3/2020	N/A	ADDED MISSING DIM (26.0mm), RELEASE FOR PRODUCTION.
A	CH	6/15/2020	N/A	INITIAL RELEASE

THE INFORMATION CONTAINED IN THIS DRAWING IS PROTECTED BY COPYRIGHT AND PATENT LAWS OF THE UNITED STATES AND OTHER COUNTRIES. ANY REPRODUCTION IN PART OR AS A WHOLE WITHOUT WRITTEN PERMISSION IS PROHIBITED.

NOTES:

PART TO BE MODELED FROM 3D CAD MODEL.
 SEE INDIVIDUAL PARTS DRAWINGS FOR SPECIFIC MATERIALS.
 NO LEAD IS ALLOWED IN BARRETTE PRODUCTS OR MATERIALS.
 NO BURRS OR SHARP EDGES ALLOWED.

MATERIAL:

410 STAINLESS STEEL
SURFACE TREATMENT:
 NONE

SURFACE FINISH:

DACROMET 320PB = BLACK OR DACROMET 500B = SILVER,
 GREATER THAN 36 GM/M².
 COLOR AS NOTED ON SHEET.

DACROMET 500 B = SILVER




(TO WITHSTAND 1000 HOURS SALT SPRAY TEST)



Test sample complies with these details.
 Deviations are noted.

Report # M1154.01-119-19

Date 5/11/21 Tech AJS

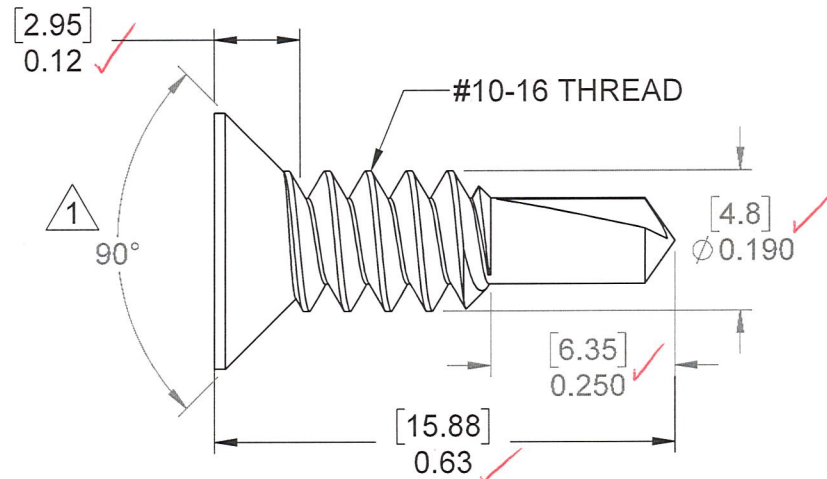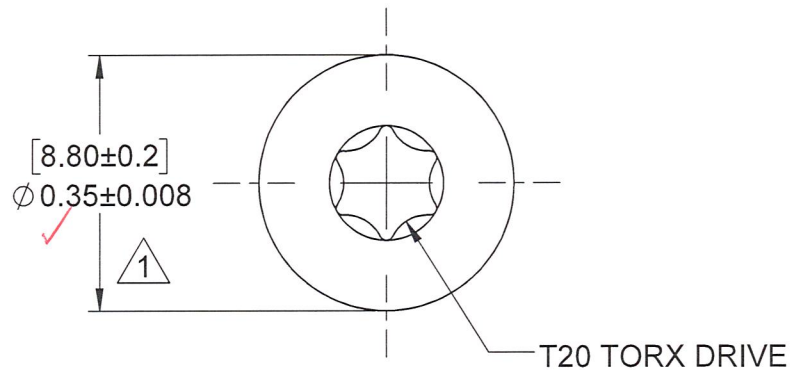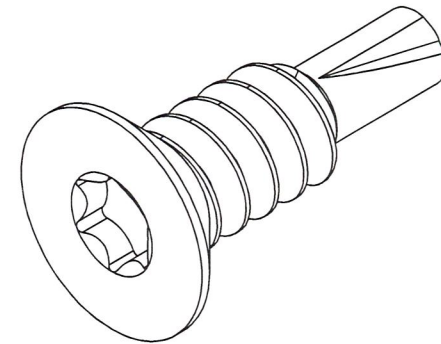

3D MODEL FILENAME EPN-6159

TOLERANCES		BARRETTE Outdoor Living	
FRACTION	±1/16	DRAWN: C HERITAGE	DATE: 11/3/2020
XX	±0.01	APPROVED: MW	
XXX	±0.005	DESCRIPTION: <u>10-16 X 5/8" T20 FH SDS 410SS</u>	
ANGLE	±1.0°	DACROMET	
FINISH	125 RMS	SHEET 1 OF 1	REVISION PART NUMBER
UNLESS OTHERWISE SPECIFIED		SCALE 4:1	EPN-6337
		WEIGHT: 0.00	

THE INFORMATION CONTAINED IN THIS DRAWING IS PROTECTED BY COPYRIGHT AND PATENT LAWS OF THE UNITED STATES AND OTHER COUNTRIES. ANY REPRODUCTION IN PART OR AS A WHOLE WITHOUT WRITTEN PERMISSION IS PROHIBITED.



REV	BY	DATE	PCR	DESCRIPTION
1	CH	12/15/2020	N/A	90 DEG. WAS 82 DEG. HEAD DIA. WAS .362 AND ADDED TOL.
0	CH	11/3/20	N/A	INITIAL RELEASE

NOTES:
 PART TO BE MODELED FROM 3D CAD MODEL.
 SEE INDIVIDUAL PARTS DRAWINGS FOR SPECIFIC MATERIALS.
 NO LEAD IS ALLOWED IN BARRETTE PRODUCTS OR MATERIALS.
 NO BURRS OR SHARP EDGES ALLOWED.

MATERIAL:
 STAINLESS STEEL TYPE 410

SURFACE TREATMENT:
 POWDER COAT (HEAD ONLY)
 - SAME AS POWDER USED ON PANEL

ALT SURFACE TREATMENT:
 DACROMET 320PB = BLACK OR DACROMET 500B = SILVER, GREATER THAN 36GM/M².
 - SALT SPRAY TEST PER ASTM B117 (PASS 1000 HOURS)

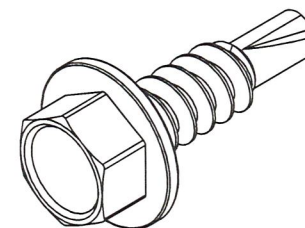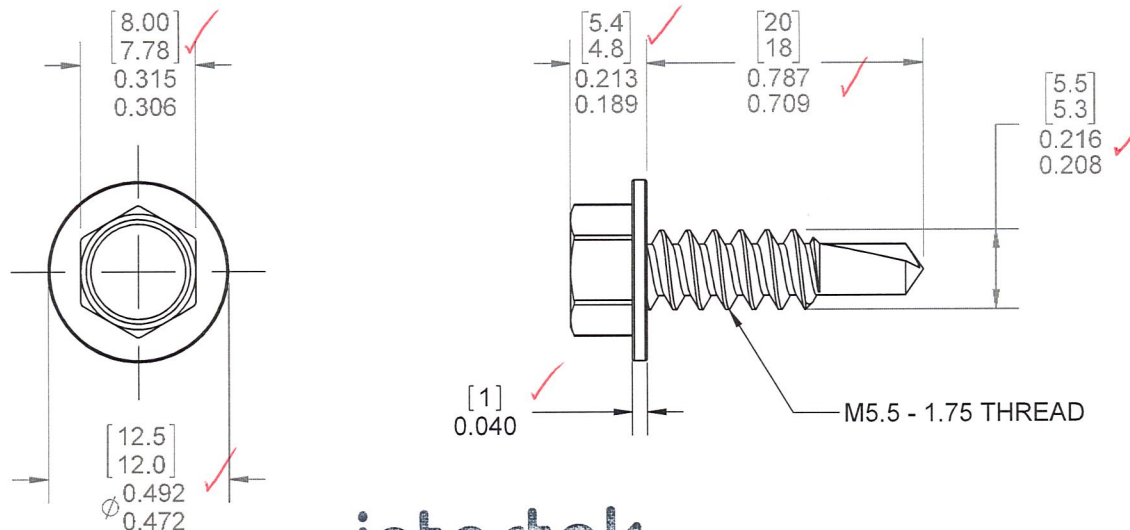

intertek

Test sample complies with these details.
 Deviations are noted.

Report # M1154-01-119-19


Date 5/11/21 Tech AJS

TOLERANCES				
FRACTION	±1/16	DRAWN: C HERITAGE	DATE: 03/23/2021	APPROVED:
XX	±0.01	DESCRIPTION: M5.5 - 1.75 X 19mm HEX HEAD SDS 410 SS		
XXX	±0.005	SHEET 1 OF 1		
ANGLE	±1.0°	SCALE 2:1		
FINISH	125 RMS	REVISION: 0		
UNLESS OTHERWISE SPECIFIED		PART NUMBER: EPN-6343		
		WEIGHT:		

THE INFORMATION CONTAINED IN THIS DRAWING IS PROTECTED BY COPYRIGHT AND PATENT LAWS OF THE UNITED STATES AND OTHER COUNTRIES. ANY REPRODUCTION IN PART OR AS A WHOLE WITHOUT WRITTEN PERMISSION IS PROHIBITED.

REV	BY	DATE	PCR	DESCRIPTION
0	CH	3/23/2021	N/A	RELEASED FOR PRODUCTION

ITEM NO.	PART NO	DESCRIPTION	QTY
1	EPN-2619	SR INFILL GROMMET	18
2	EPN-6343	M5.5 - 1.75 X 19mm HEX HEAD SDS 410 SS	4
3	EPN-8221	SR HORIZ 8'X42" LEVEL INFILL	1
4	EPN-8226	SR HORIZ LEVEL END BALUSTER, 42"	2

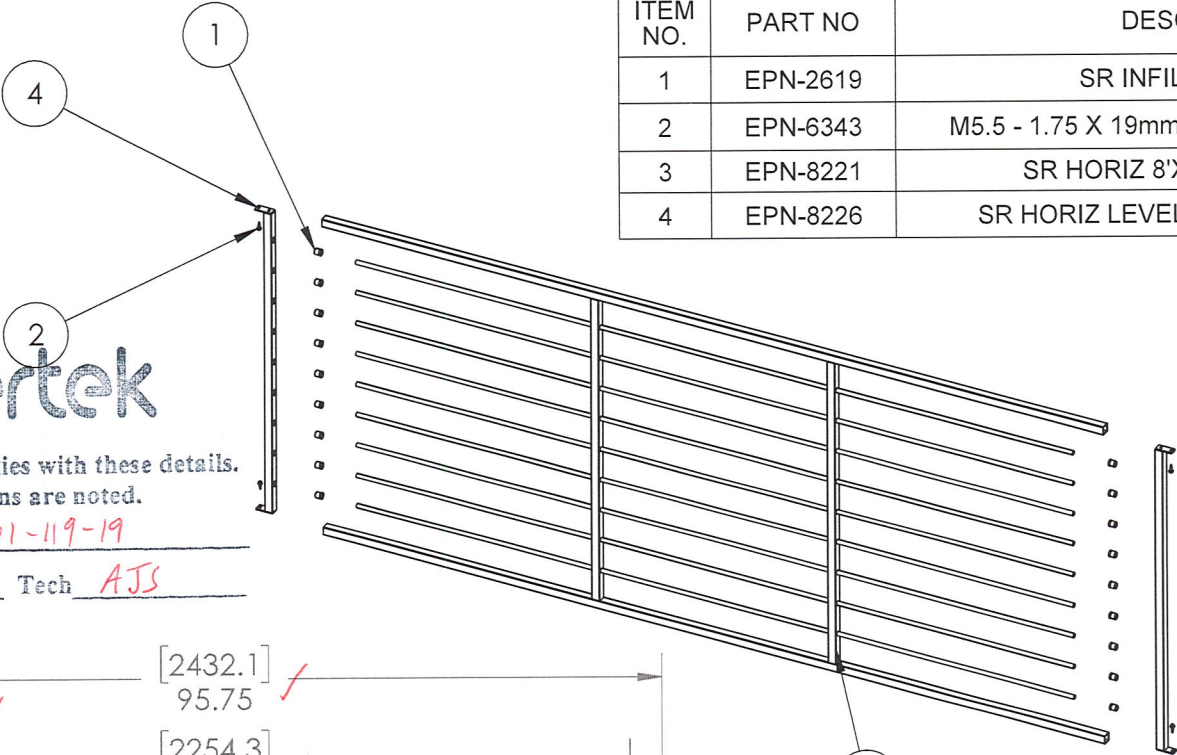


intertek

Test sample complies with these details.
Deviations are noted.

Report # M1154-01-119-19

Date 5/11/21 Tech AJS

SCALE 1 : 20

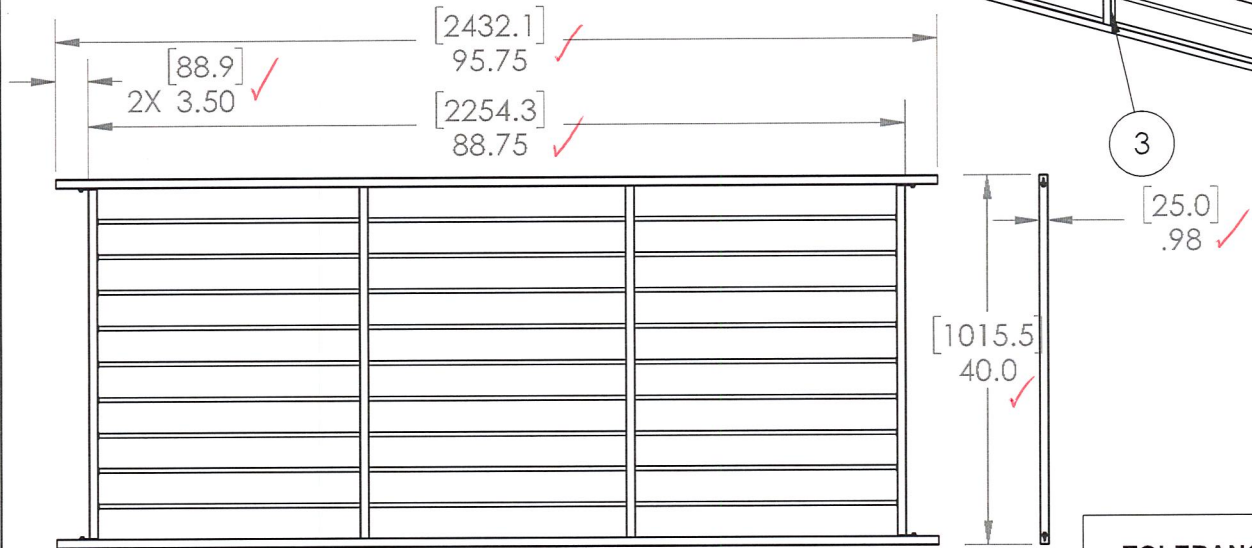

NOTES:

- 1) USE SAME POWDER COAT PROCESS AS METAL WORKS EXCALIBUR.
- 2) COLOR MUST MATCH BOL SAMPLE.

TOLERANCES		 BARRETTE Outdoor Living	
FRACTION	±1/16	DRAWN	C HERITAGE
XX	±0.01	DATE	08/21/2020
XXX	±0.005	APPROVED	PS
ANGLE	±1.0°	DESCRIPTION SR HORIZ 8'X42" LEVEL PANEL	
FINISH	125 RMS	SHEET 1 OF 1	REVISION
UNLESS OTHERWISE SPECIFIED		SCALE 1:15	PART NUMBER
		WEIGHT: 47.353	EPN-8220

REV	BY	DATE	PCR	DESCRIPTION
2	CH	3/29/2021	210325CJH-A	CHANGED TO BIGGER SCREW; EPN-6343 WAS EPN-6329.
1	CH	1/4/2021	N/A	UPDATED DESCRIPTION
0	CH	8/21/2020	N/A	RELEASED FOR PRODUCTION

THE INFORMATION CONTAINED IN THIS DRAWING IS PROTECTED BY COPYRIGHT AND PATENT LAWS OF THE UNITED STATES AND OTHER COUNTRIES. ANY REPRODUCTION IN PART OR AS A WHOLE WITHOUT WRITTEN PERMISSION IS PROHIBITED.


ITEM NO.	PART NO	DESCRIPTION	QTY
1	EPN-3067	8' LEVEL RAIL, 25MM SQ, 2.5MM WALL, Q345 ALLOY	2
2	EPN-3060	SR 25mm Sq 15 GAUGE BALUSTER MID LEVEL 38"	2
3	EPN-3061	SR 12MM ROUND, 8FT	9

intertek


Test sample complies with these details.
Deviations are noted.

Report # M1154-01-119-19

Date 5/11/21 Tech AJS

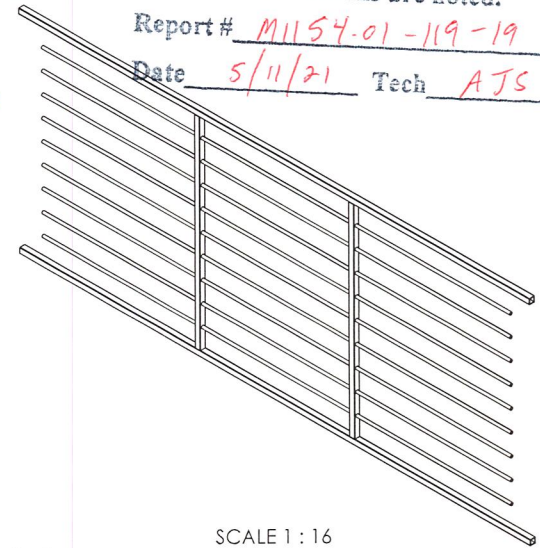

SCALE 1 : 16

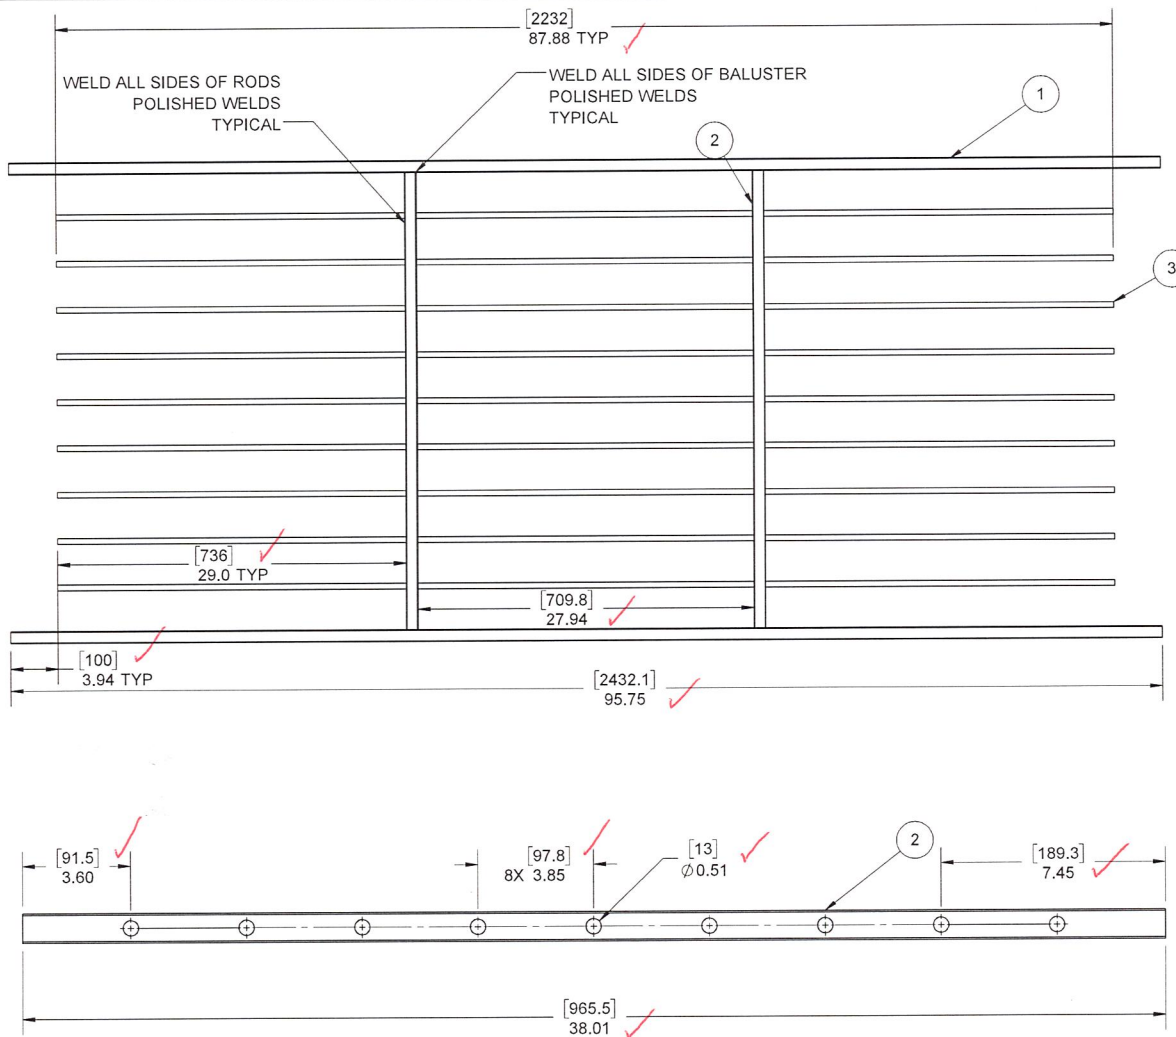

THE INFORMATION CONTAINED IN THIS DRAWING IS PROTECTED BY COPYRIGHT AND PATENT LAWS OF THE UNITED STATES AND OTHER COUNTRIES. ANY REPRODUCTION IN PART OR AS A WHOLE WITHOUT WRITTEN PERMISSION IS PROHIBITED.

REV	BY	DATE	PCR	DESCRIPTION
1	GS	9/17/2020	N/A	REPLACED EPN-3008 WITH EPN-3067
0	CH	8/21/2020	N/A	RELEASED FOR PRODUCTION

TOLERANCES		DRAWN BY		DATE		APPROVED BY	
FRACTION	±1/16	C HERITAGE		08/21/2020		CH	
XX	±0.01	SR HORIZ 42"X96" LEVEL INFILL					
XXX	±0.005	SHEET 1 OF 1					
ANGLE	±1.0°	SCALE 1:16					
FINISH	125 RMS	WEIGHT: 46.11					
UNLESS OTHERWISE SPECIFIED		REVISION		PART NUMBER		EPN-8221	



Total Quality. Assured.

130 Derry Court
York, Pennsylvania 17406

Telephone: 717-764-7700
Facsimile: 717-764-4129
www.intertek.com/building

TEST REPORT FOR BARRETTE OUTDOOR LIVING, INC.

Report No.: M1154.01-119-19 R0

Date: 05/18/21

SECTION 13

REVISION LOG

REVISION #	DATE	PAGES	REVISION
0	05/18/21	N/A	Original Report Issue